

NOTE

- 1/ LEVELS ARE IN TERMS OF LINZ DATUM
- 2/ USE OF THIS PLAN FOR PURPOSES BEYOND THE JOB SCOPE IS NOT RECOMMENDED.
- 3 / THERE MAY BE SERVICES NOT SHOWN ON THIS PLAN.
- 4 / POSITIONS WITH + INDICATE SURVEYED POSITION (LEVEL ON TOP OF PIPE OR CONDUITT)
- 5 / MANHOLES ARE ALL SURVEYED UNLESS STATED OTHERWISE ON THE PLAN FACE.
- 6 / LINES WITHOUT + ARE OF VARYING DEGREES OF ACCURACY. (SOME ARE PLOTTED BY TRENCH LOCATION AND SOME ARE PLOTTED BY RECOLLECTION.)
- 7 / COORDINATES ARE GEODETIC 1949 MT EDEN CIRCUIT.




SERVICES ASBUILT PLAN

AUT AKORANGA CAMPUS
NEW LECTURE THEATRES

SCALE A2 1 : 250

REV B

- A - 16.03.2009 EXTRA
- B 24.09.2009 ADDED GRATES HOLDING TANK INFO

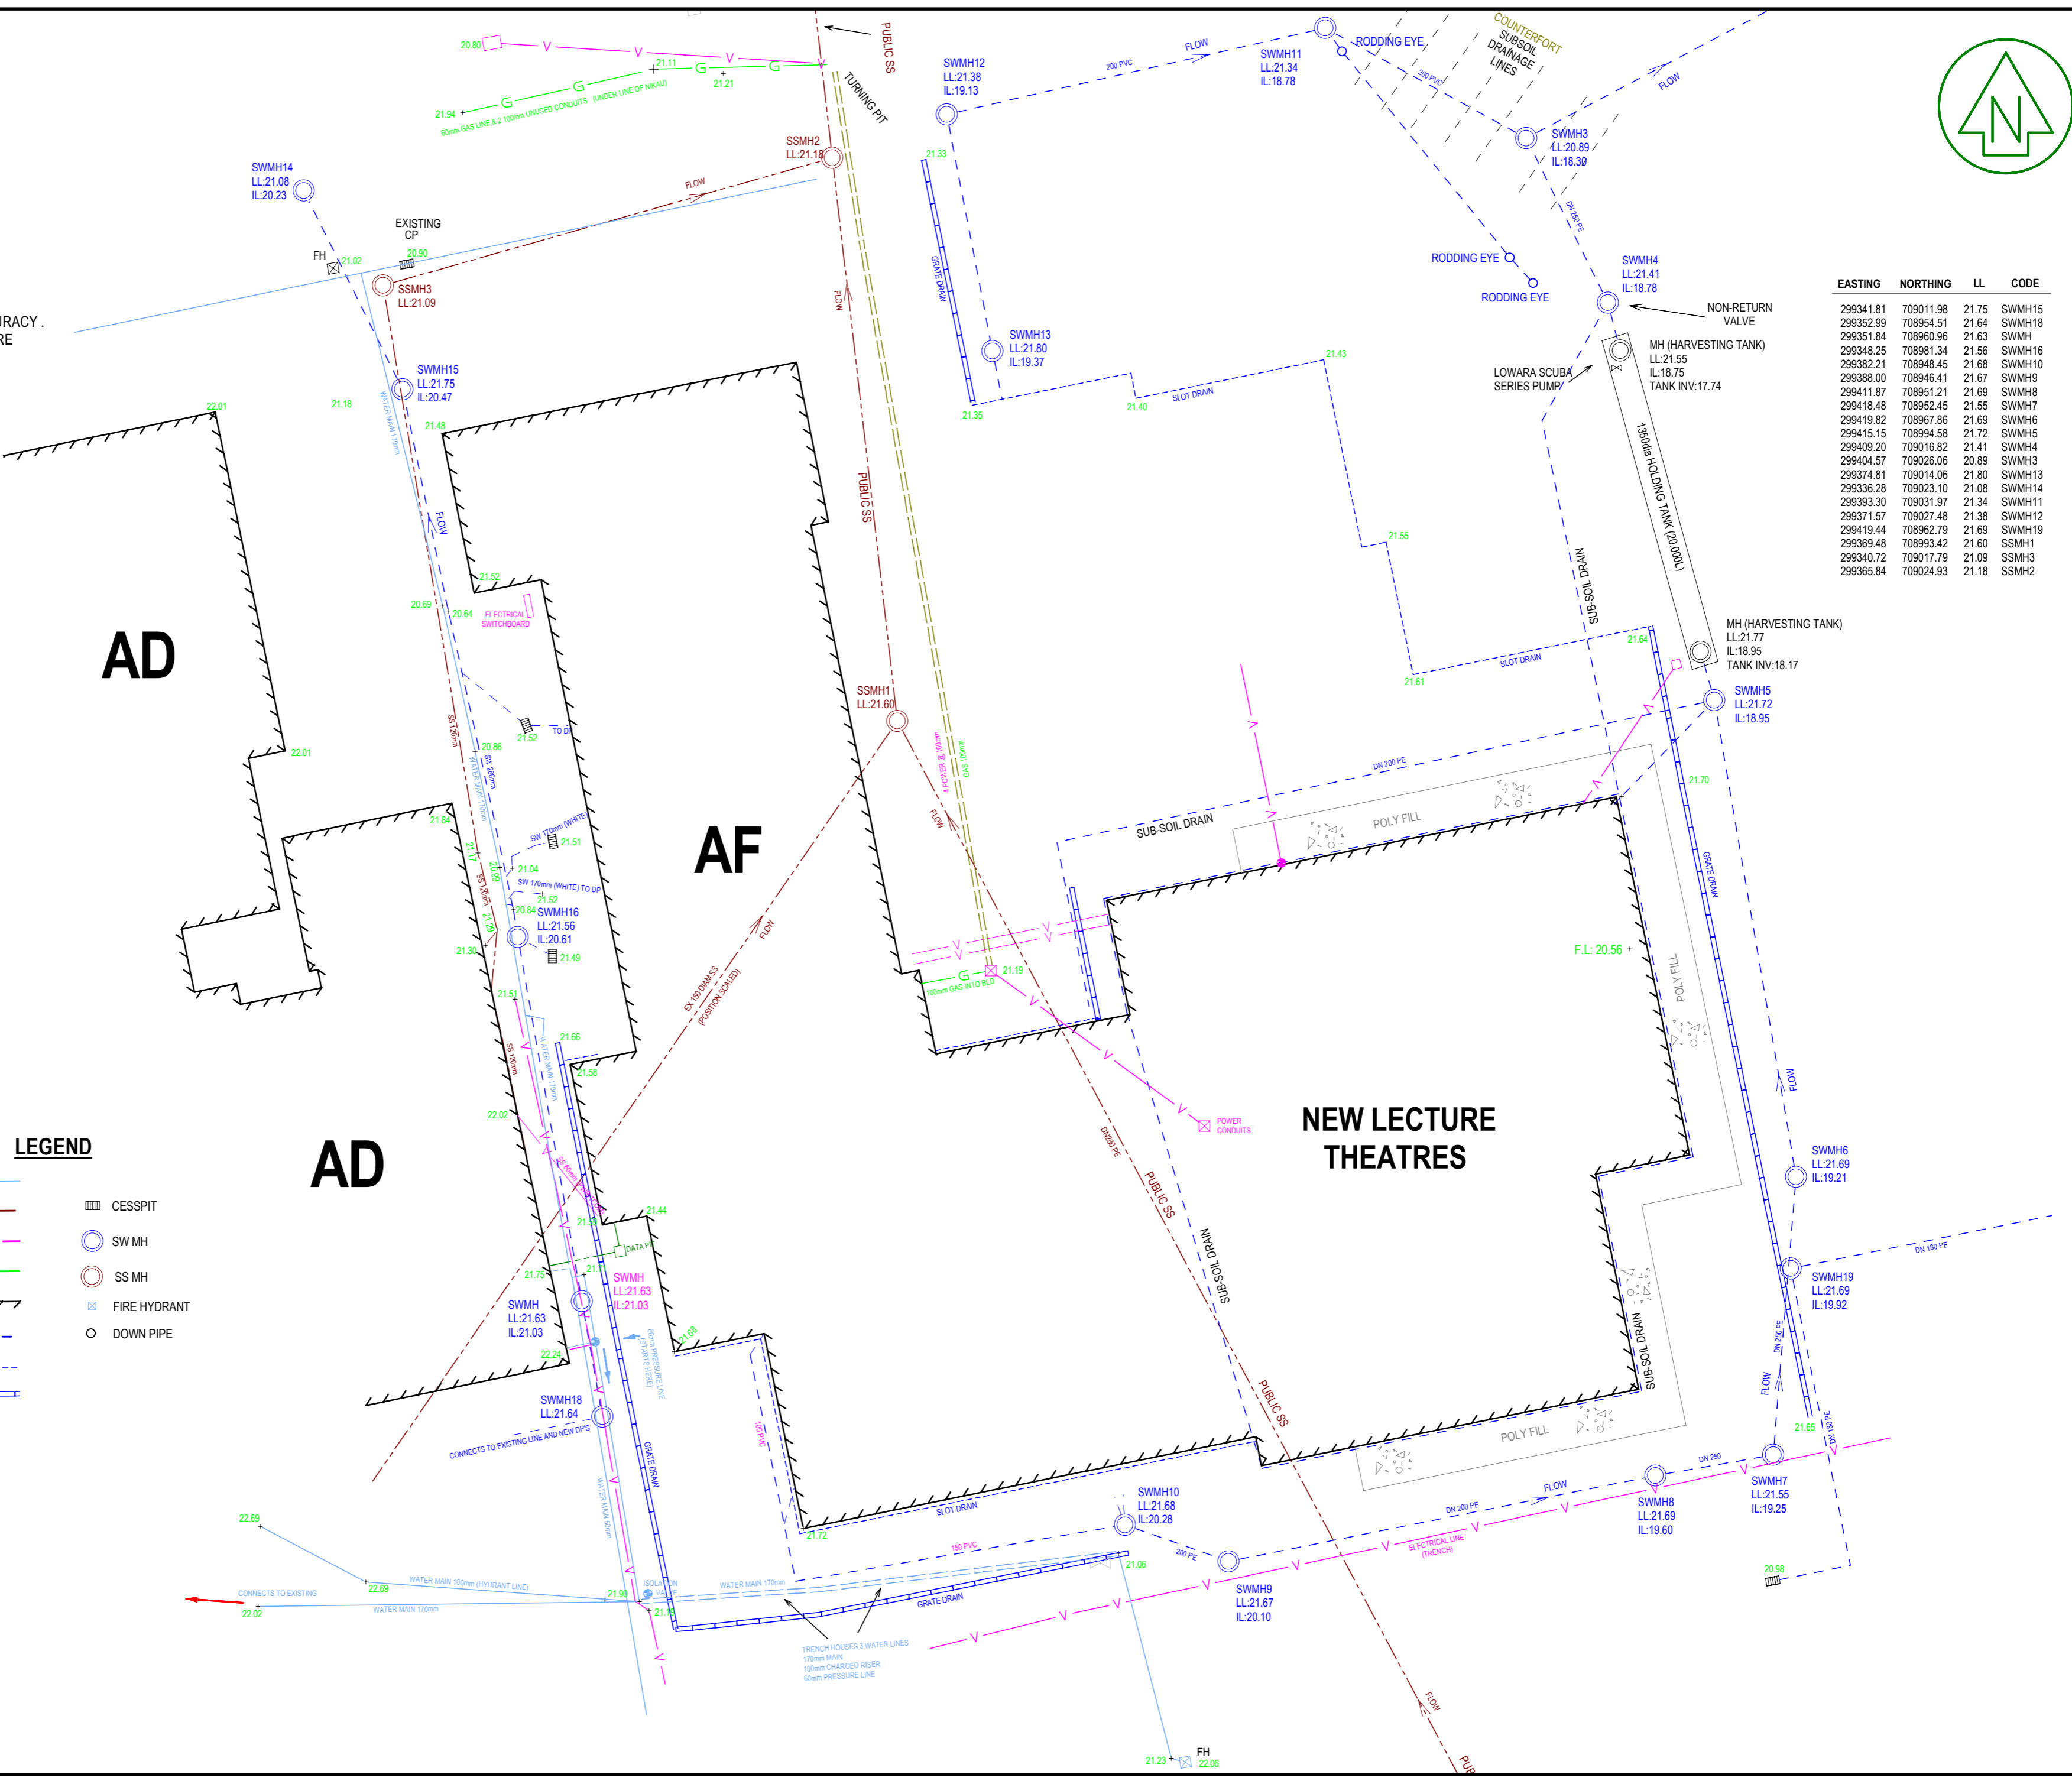

EASTING	NORTHING	LL	CODE
299341.81	709011.98	21.75	SWMH15
299352.99	708954.51	21.64	SWMH18
299351.84	708960.96	21.63	SWMH
299348.25	708981.34	21.56	SWMH16
299382.21	708948.45	21.68	SWMH10
299388.00	708946.41	21.67	SWMH9
299411.87	708951.21	21.69	SWMH8
299418.48	708952.45	21.55	SWMH7
299419.82	708967.86	21.69	SWMH6
299415.15	708994.58	21.72	SWMH5
299409.20	709016.82	21.41	SWMH4
299404.57	709026.06	20.89	SWMH3
299374.81	709014.06	21.80	SWMH13
299336.28	709023.10	21.08	SWMH14
299393.30	709031.97	21.34	SWMH11
299371.57	709027.48	21.38	SWMH12
299419.44	708962.79	21.69	SWMH19
299369.48	708993.42	21.60	SSMH1
299340.72	709017.79	21.09	SSMH2
299365.84	709024.93	21.18	SSMH3

LEGEND

- WATER MAIN
- SANITARY SEWER
- POWER
- GAS
- BUILDING
- STORMWATER
- 10mm SLOT DRAIN
- 100mm GRATED DRAIN
- CESSPIT
- SW MH
- SS MH
- FIRE HYDRANT
- DOWN PIPE

MIKE WEBBER SURVEYORS
LICENSED CADASTRAL SURVEYORS



PO BOX 11411, ELLERSLIE
PH 09 579 8411, FAX 09 579 8412, MOB 021 976 589